


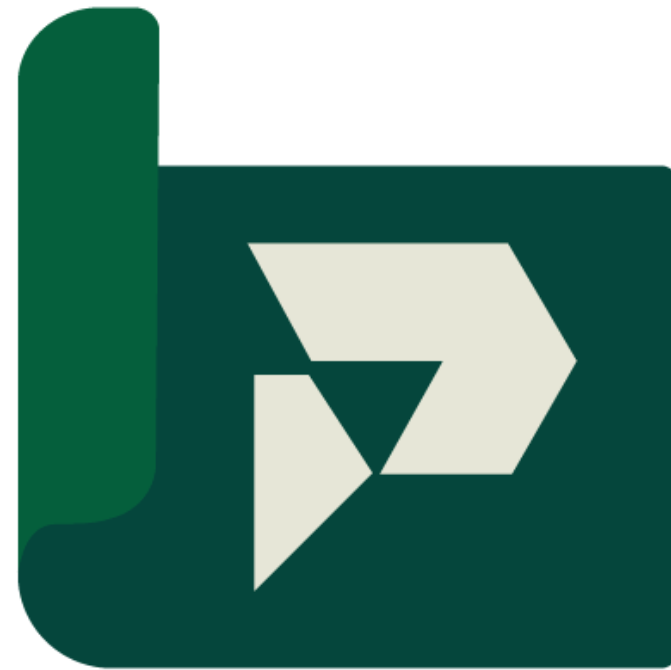

## Site Survey, Existing Drawings

Proposal prepared by:

**Plan Craft Daily Ltd**

<https://plancraftdaily.co.uk/>

[contact@plancraftdaily.co.uk](mailto:contact@plancraftdaily.co.uk)

[07472360422](tel:07472360422)

**Plan Craft Daily Ltd**

Registered Company Number:  
**16240187**

VAT Registration Number:  
**509715088**

Silverstream House 45 Fitzroy Street,  
Fitzrovia, London, W1T 6EB

Proposal prepared for:

\*\*\*

Proposal prepared on:

\*\*\*

Valid till:

\*\*\*

Hi,

This letter is in regard to your project “\*\*\*\*”. After researching your property, we have created a quotation for the preparation of Existing drawings.

The final drawings will be delivered within **6 - 10 working days** after the day of the survey.

Please note that if the project complexity increases, we may require **additional time** to ensure accuracy and maintain the quality of our work. We’ll keep you informed in such cases.

|                         |  |           |
|-------------------------|--|-----------|
| SURVEY AT “****”:       |  | £1,600.00 |
| Measured Survey         |  | £1,200.00 |
| Topographical Survey    |  | £400.00   |
| Existing Drawings       |  | £1,400.00 |
| 1x Ground Floor Plan    |  |           |
| 1x First Floor Plan     |  |           |
| 1x Second Floor Plan    |  |           |
| 1x Roof Plan            |  |           |
| North & South Elevation |  |           |
| East & West Elevation   |  |           |
| 4x Sections             |  |           |
| 1x Site Plan            |  |           |

|            |          |
|------------|----------|
| Extras:    | £00.00   |
| Subtotal:  | £3000.00 |
| Discount : | £00.00   |

Total (Incl. 20% VAT): £3,600.00

DRAWING NOTES:

All dimensions to be verified on site. Do not scale from this drawing.

Existing drawings are based on site measurements and available information. Any discrepancies should be reported immediately.

Not to be used for construction purposes.

All dimensions in millimeters unless otherwise stated

PROJECT NOTES:

TITLE:  
**EXISTING  
GROUND FLOOR PLAN**

PROJECT  
ADDRESS:

DRAWING: 001

DATE: 24.07.2025

PAPER SIZE: A2

SCALE: 1:100


REVISION:

DRAWN BY: EB


CHECKED BY: HP

REVISION BY: HP

NORTH:

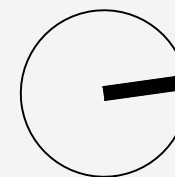


SCALE:

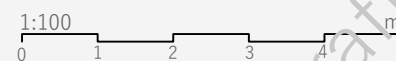

REVISION NOTES:

001 - multiple corrections as per client's request

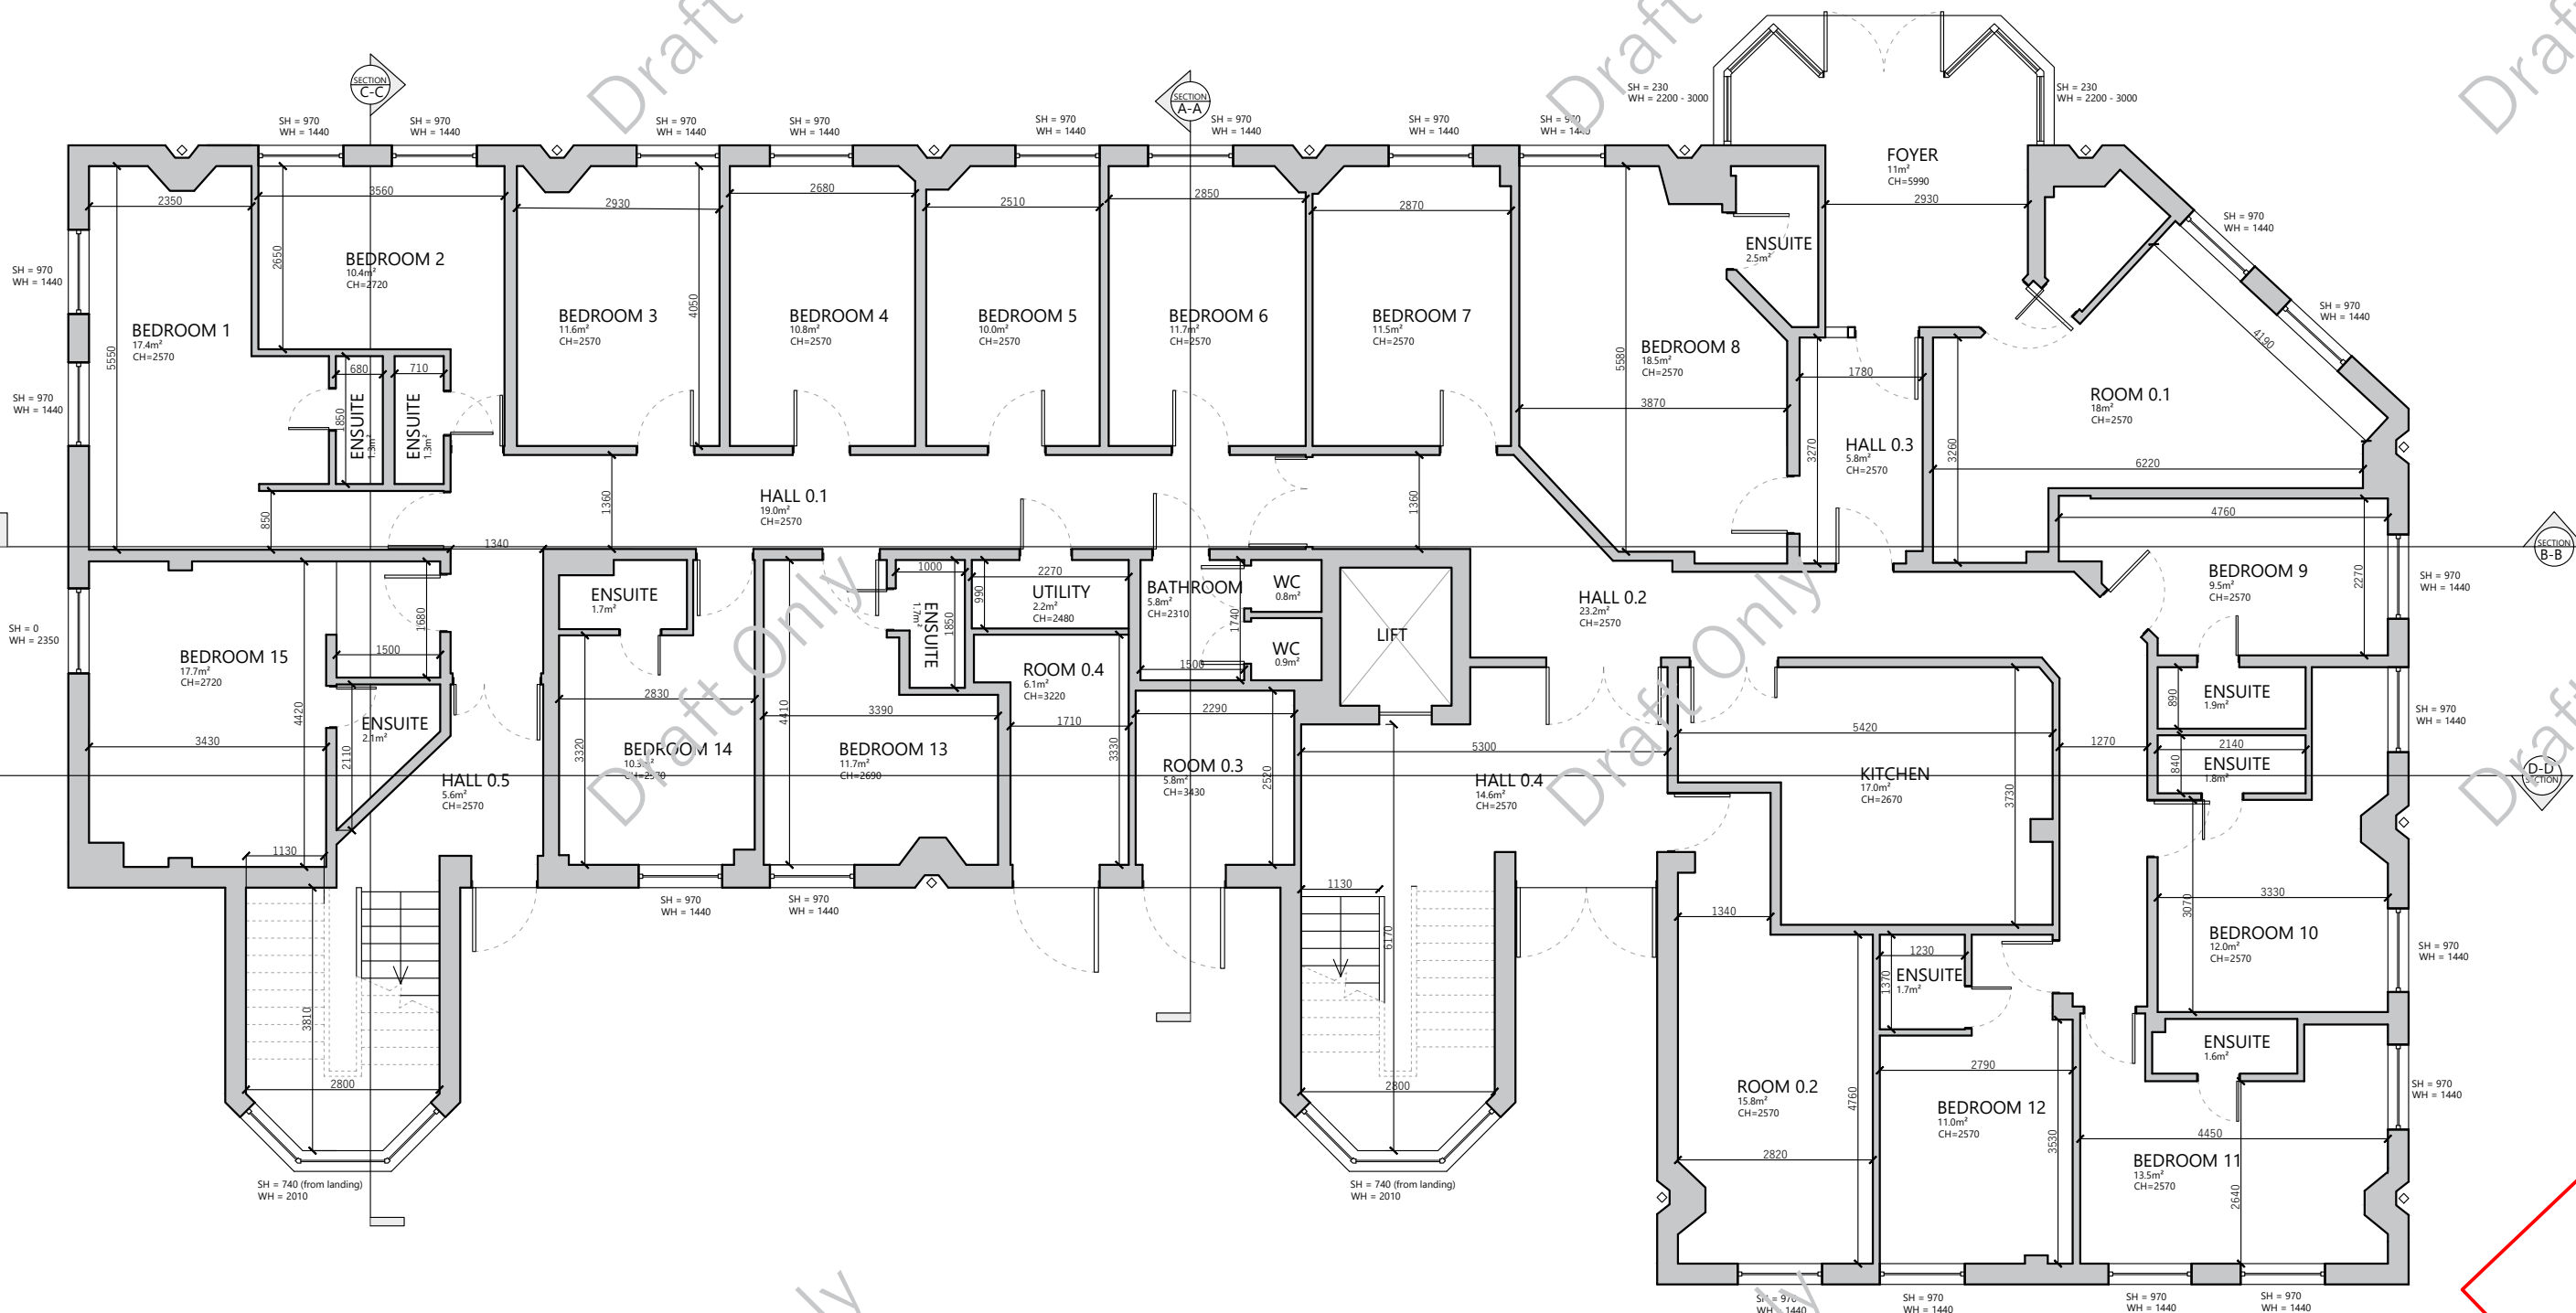

**EXISTING GROUND FLOOR PLAN**



DRAWING NOTES:

All dimensions to be verified on site. Do not scale from this drawing.

Existing drawings are based on site measurements and available information. Any discrepancies should be reported immediately.

Not to be used for construction purposes.

All dimensions in millimeters unless otherwise stated

PROJECT NOTES:

TITLE:  
**EXISTING  
FIRST FLOOR PLAN**

PROJECT  
ADDRESS:

DRAWING: 002

DATE: 24.07.2025

PAPER SIZE: A2

SCALE: 1:100


REVISION:

DRAWN BY: EB

CHECKED BY: HP

REVISION BY: HP

NORTH:

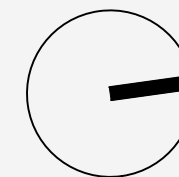


SCALE:




REVISION NOTES:

001 - multiple corrections as per client's request

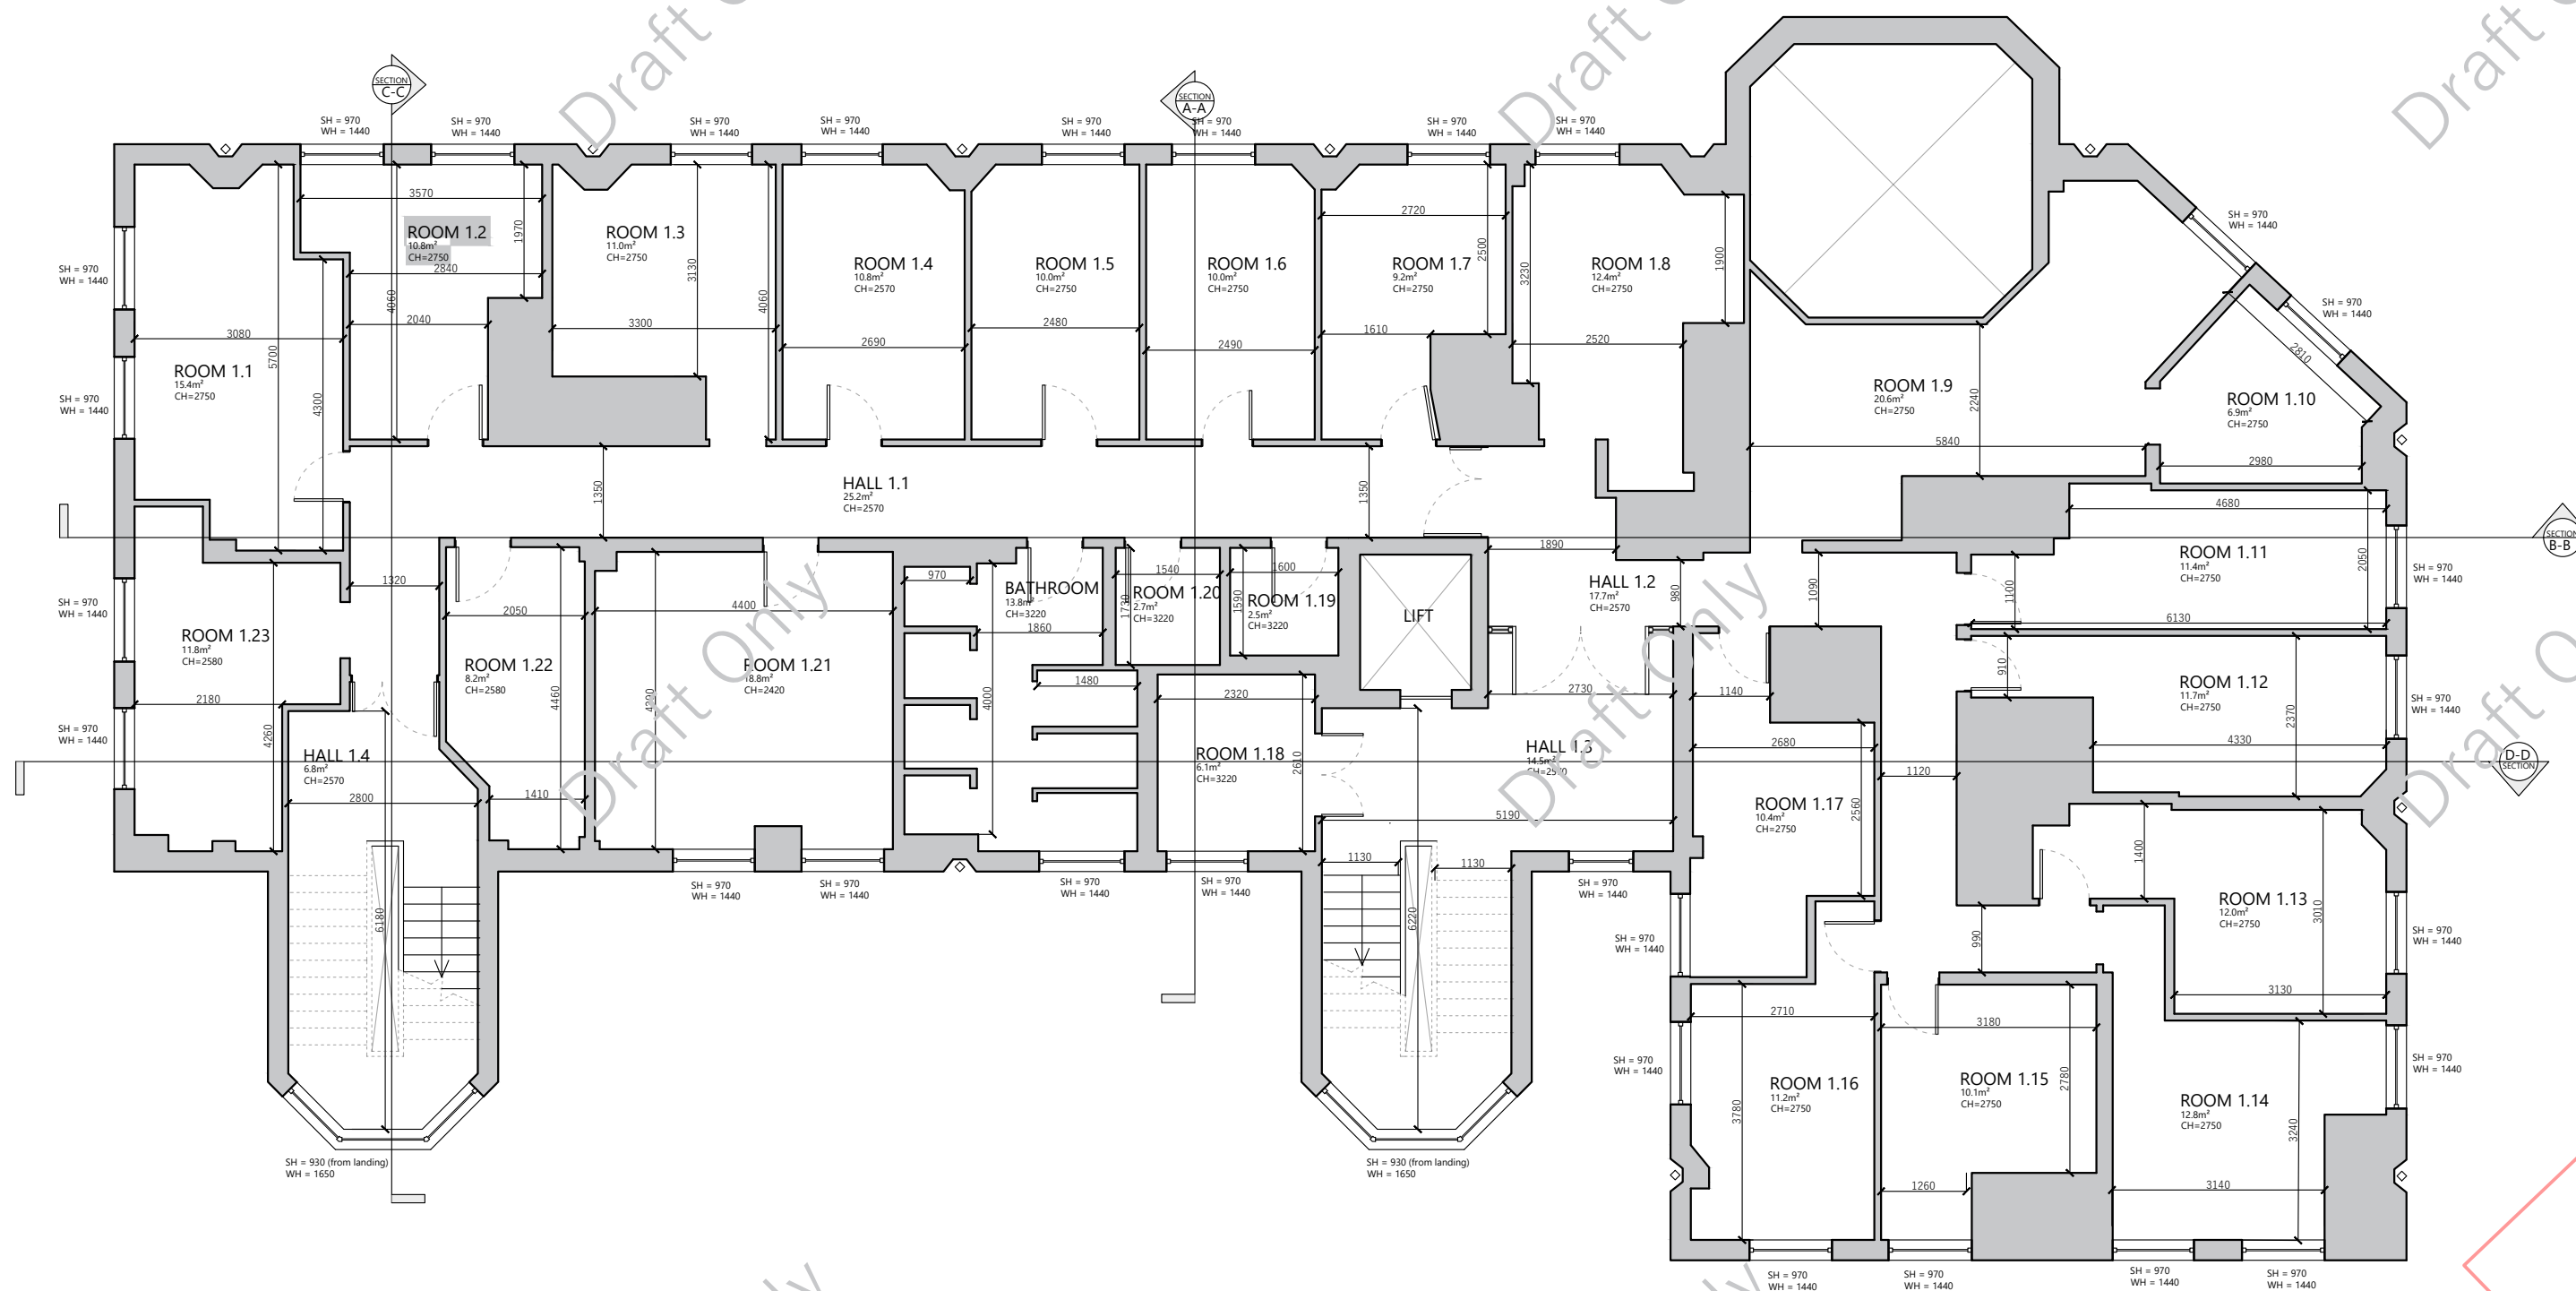

**EXISTING FIRST FLOOR PLAN**



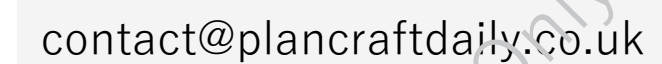

All dimensions to be verified on site. Do not scale from this drawing.

Not to be used for construction purposes.  
All dimensions in millimeters unless otherwise stated

## PROJECT ADDRESS:

DRAWING: 003

DATE: 24.07.2025

PAPER SIZE: ~~A2~~

SCALE: 1:100


REVISION:

DRAWN BY: EB


CHECKED BY: HP

REVISION BY:

NORTH: 

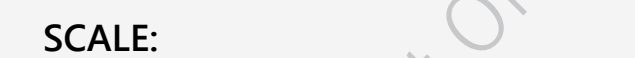

REVISION NOTES:

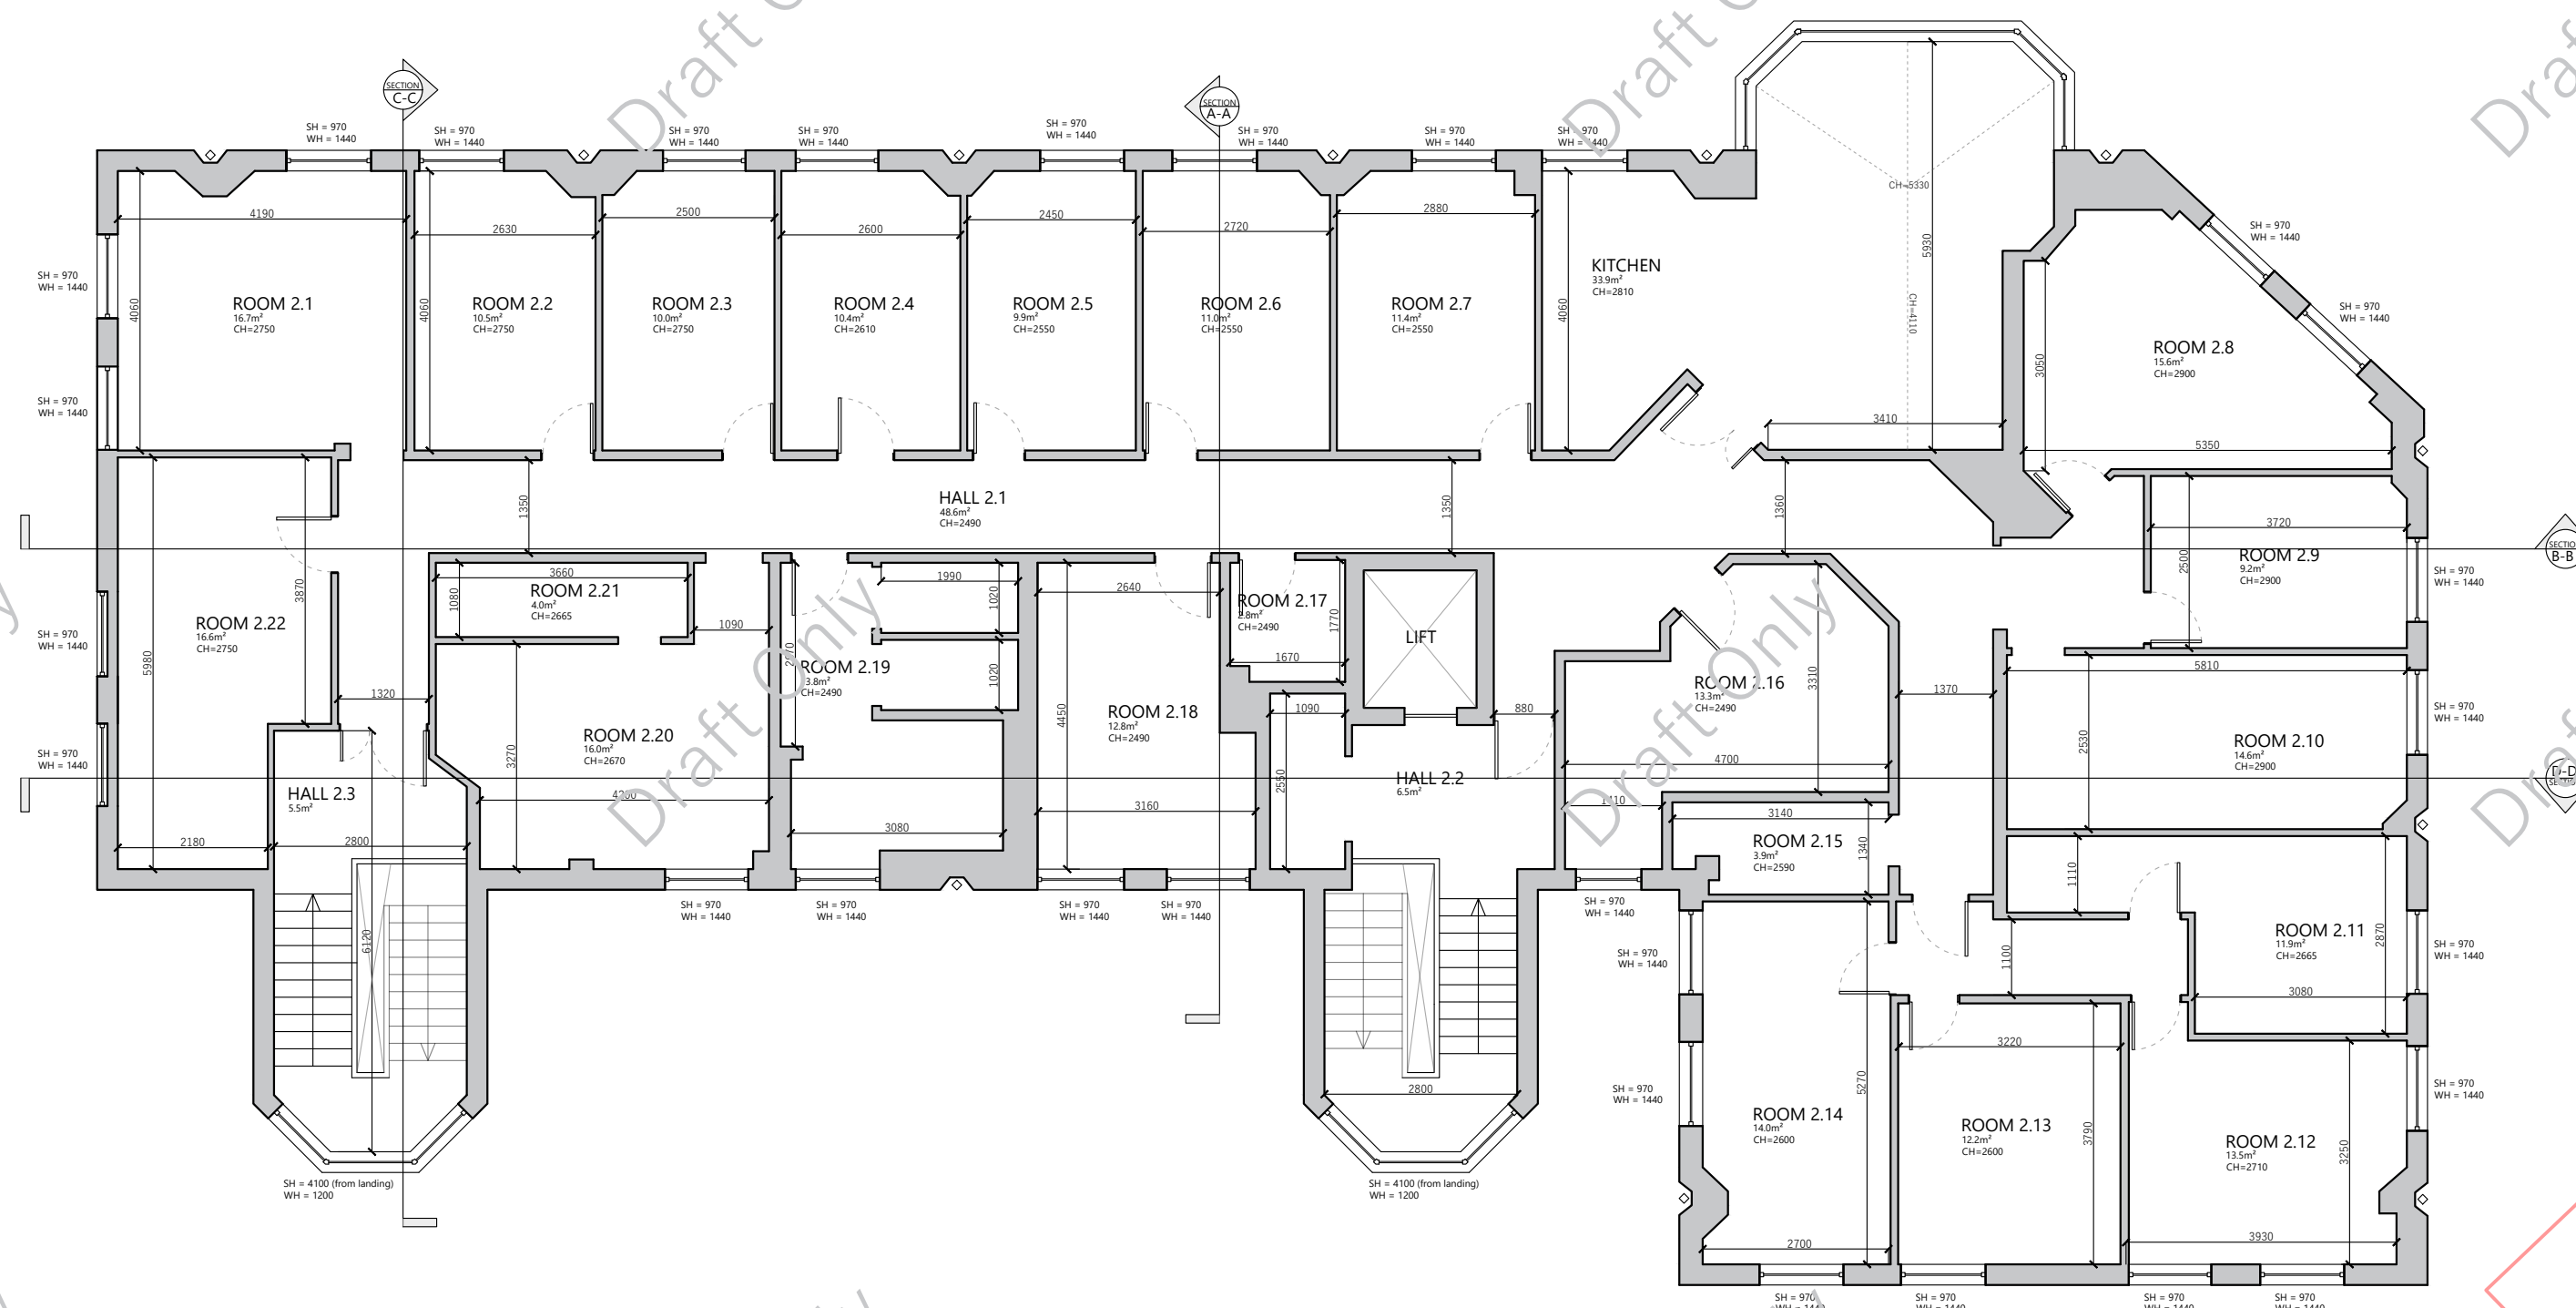

EXISTING SECOND FLOOR PLAN

DRAWING NOTES:

All dimensions to be verified on site. Do not scale from this drawing.

Existing drawings are based on site measurements and available information. Any discrepancies should be reported immediately.

Not to be used for construction purposes.

All dimensions in millimeters unless otherwise stated

PROJECT NOTES:

TITLE:

EXISTING  
ROOF PLAN

PROJECT  
ADDRESS:

DRAWING: 004

DATE: 24.07.2025

PAPER SIZE: A2

SCALE: 1:100


REVISION:

DRAWN BY: EB


CHECKED BY: HP

REVISION BY: HP

NORTH:

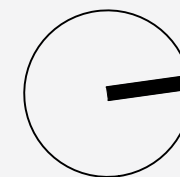

SCALE:

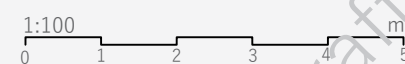

REVISION NOTES:

001 - multiple corrections as per client's request

D EXISTING ROOF PLAN



DRAWING NOTES:

All dimensions to be verified on site. Do not scale from this drawing.

Existing drawings are based on site measurements and available information. Any discrepancies should be reported immediately.

Not to be used for construction purposes.

All dimensions in millimeters unless otherwise stated

PROJECT NOTES:

TITLE:

EXISTING

EAST & WEST ELEVATION

PROJECT

ADDRESS:

DRAWING:

005

DATE:

24.07.2025

PAPER SIZE:

A2

SCALE:

1:100

REVISION:

DRAWN BY:

EB

CHECKED BY:

HP

REVISION BY:

HP

NORTH:

N/A

SCALE:

1:100  
0 1 2 3 4 5 m

REVISION NOTES:

001 - multiple corrections as per client's request



E

EXISTING WEST ELEVATION



F

EXISTING EAST ELEVATION

DRAWING NOTES:

All dimensions to be verified on site. Do not scale from this drawing.

Existing drawings are based on site measurements and available information. Any discrepancies should be reported immediately.

Not to be used for construction purposes.

All dimensions in millimeters unless otherwise stated

PROJECT NOTES:

TITLE:

EXISTING

NORTH & SOUTH ELEVATION

PROJECT ADDRESS:

DRAWING: 006

DATE: 24.07.2025

PAPER SIZE: A2

SCALE: 1:100

REVISION:

DRAWN BY: EB

CHECKED BY: HP

REVISION BY: HP

NORTH:  
N/A

SCALE:  
1:100  
0 1 2 3 4 5

REVISION NOTES:  
001 - multiple corrections as per client's request



G EXISTING SOUTH ELEVATION



H EXISTING NORTH ELEVATION





contact@plancraftdaily.co.uk

**DRAWING NOTES:**

All dimensions to be verified on site. Do not scale from this drawing.

Existing drawings are based on site measurements and available information. Any discrepancies should be reported immediately.

Not to be used for construction purposes

All dimensions in millimeters unless otherwise stated

**PROJECT NOTES:**

**TITLE:**

## EXISTING SECTION AA & BB

PROJECT ADDRESS:

DRAWING: 007

DATE: 24.07.2025

PAPER SIZE:  A2

SCALE: 1:100

**REVISION:**

DRAWN BY: EB


CHECKED BY: HP

REVISION BY: HP

**NORTH:**


N/A

**SCALE:**

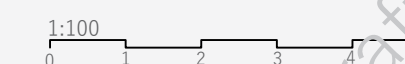


REVISION NOTES:

001 - multiple corrections as per client's request

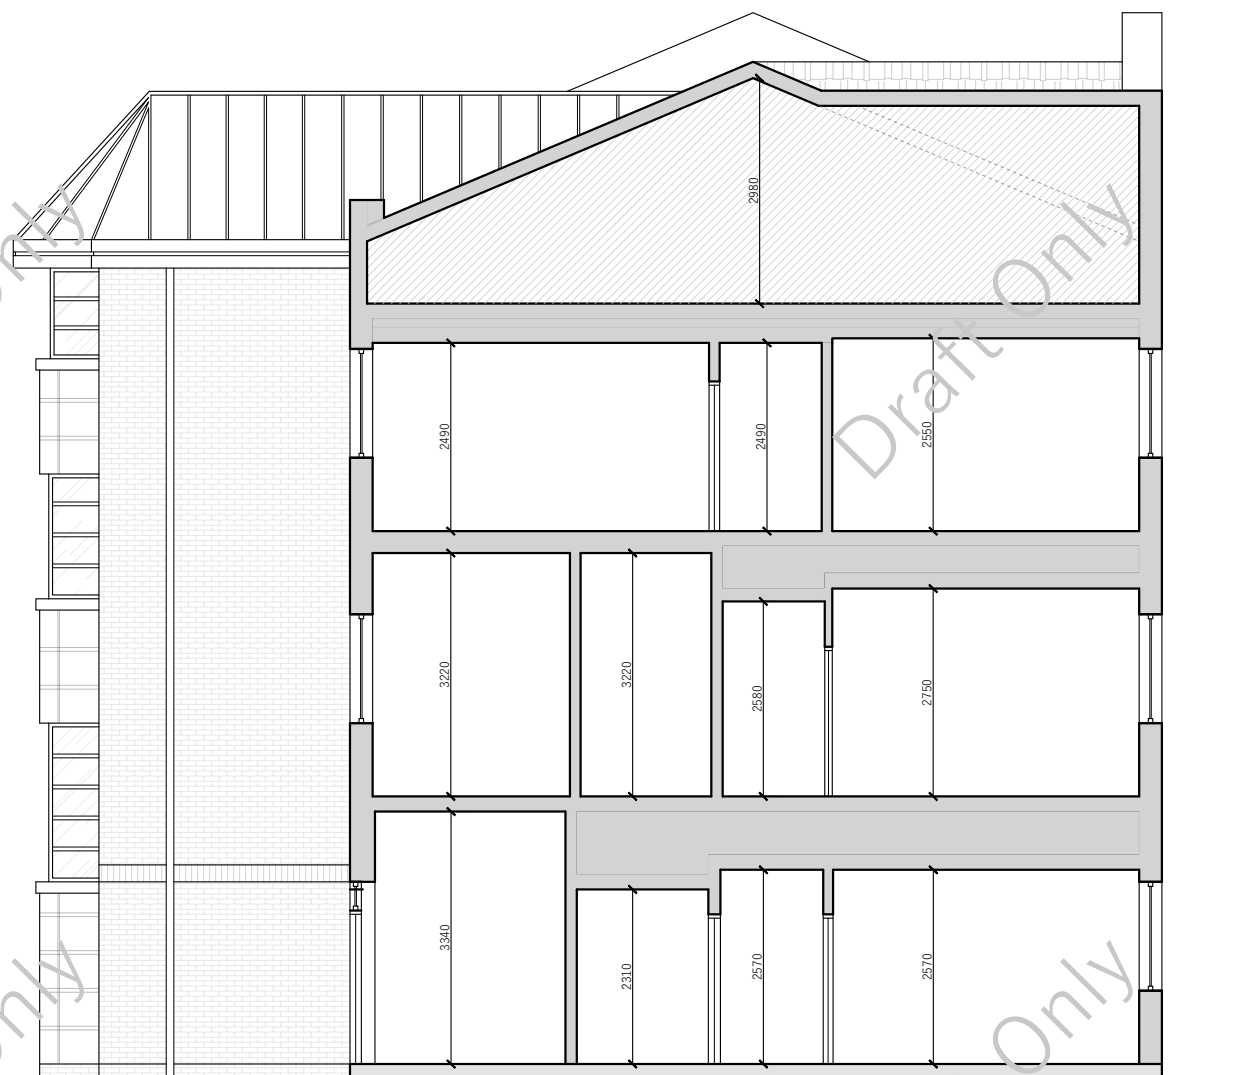

EXISTING SECTION AA

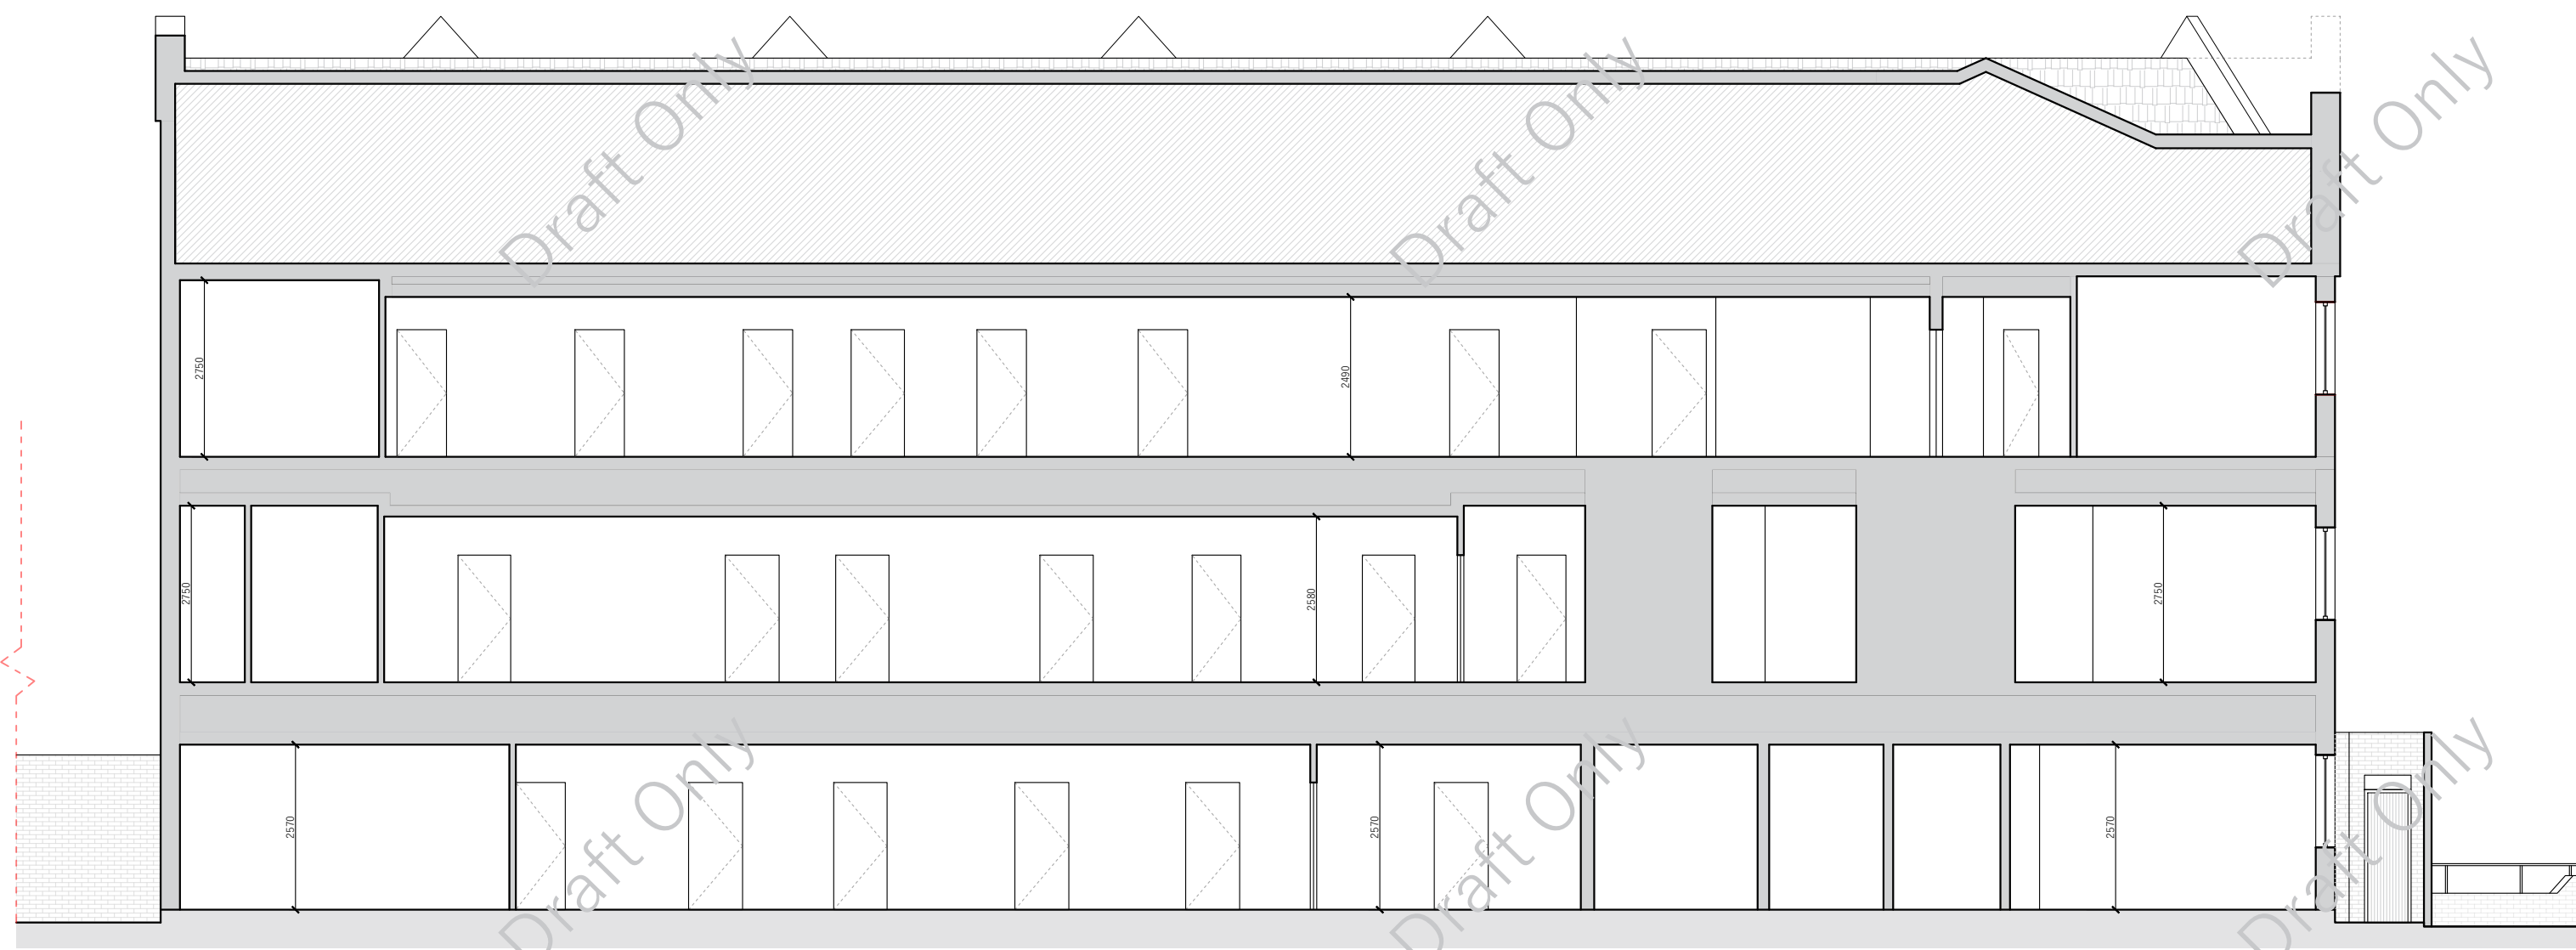

EXISTING SECTION BB



contact@plancraftdaily.co.uk

**DRAWING NOTES:**

All dimensions to be verified on site. Do not scale from this drawing.

Existing drawings are based on site measurements and available information. Any discrepancies should be reported immediately.

Not to be used for construction purposes.

All dimensions in millimeters unless otherwise stated

PROJECT NOTES:

**TITLE:**

## EXISTING SECTION CC & DD

PROJECT ADDRESS:

DRAWING: 008

DATE: 24.07.2025

PAPER SIZE: ~~A2~~

SCALE: 1:100

**REVISION:**

DRAWN BY: EB


CHECKED BY: HP

REVISION BY: HP

NORTH:

N/A

**SCALE:**

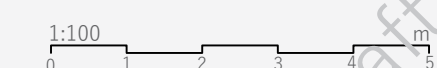

REVISION NOTES:

001 - multiple corrections as per client's request



EXISTING SECTION CC



EXISTING SECTION DD



DRAWING NOTES:

All dimensions to be verified on site. Do not scale from this drawing.  
Existing drawings are based on site measurements and available information. Any discrepancies should be reported immediately.  
Not to be used for construction purposes.  
All dimensions in millimeters unless otherwise stated

PROJECT NOTES:

TITLE:  
**EXISTING  
SITE PLAN**

PROJECT  
ADDRESS:

DRAWING: 009

DATE: 24.07.2025

PAPER SIZE: A2



SCALE: 1:200

REVISION:

DRAWN BY: EB


CHECKED BY: HP

REVISION BY: HP

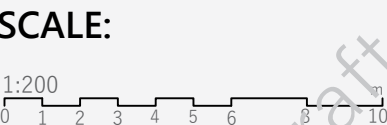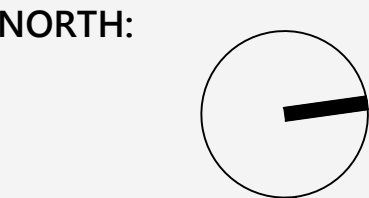

REVISION NOTES:

001 - multiple corrections as per client's request

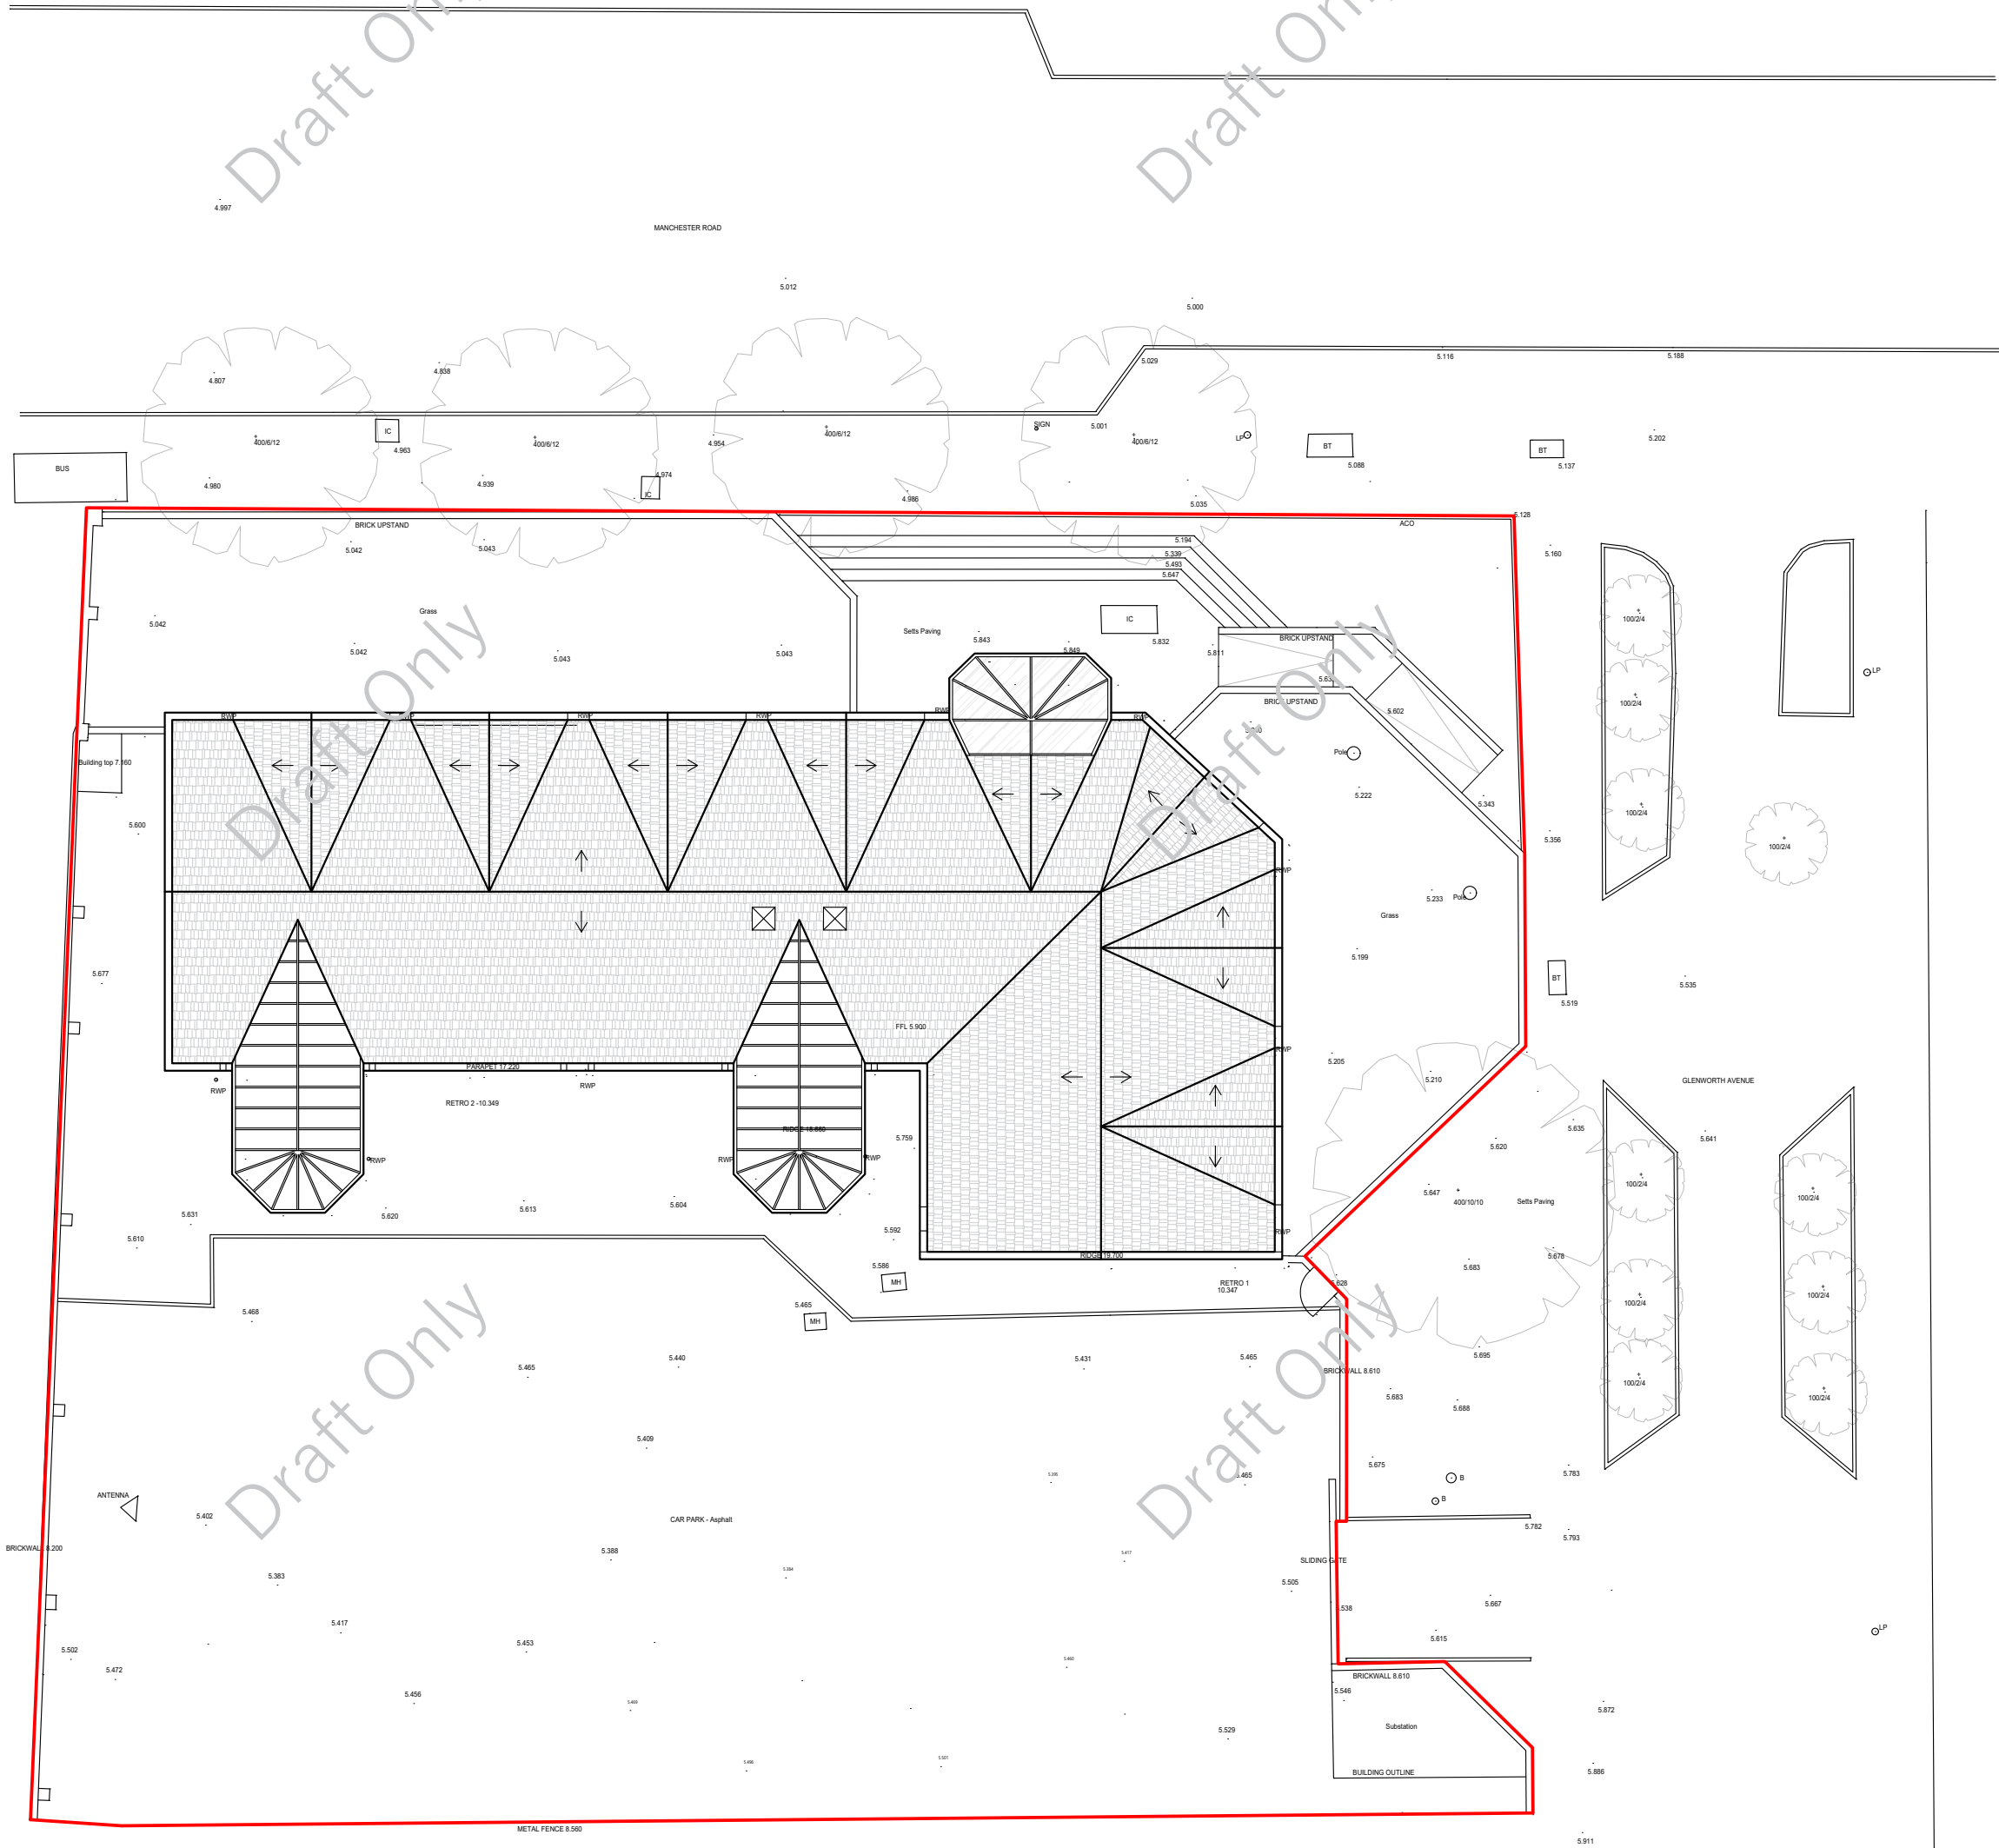

(M) EXISTING SITE PLAN



**Note:**

**Site images** are also shared both external and internal views, some of which are seen below.

**6 Site Internal Movies** also provided.

**3 Drone Videos** also provided.

